


NOTA:  
RACCHIUSE NELLE INVOLUETTE SONO INDICATE LE PARTI DI IMPIANTO REALIZZATE DA CO.I.L.

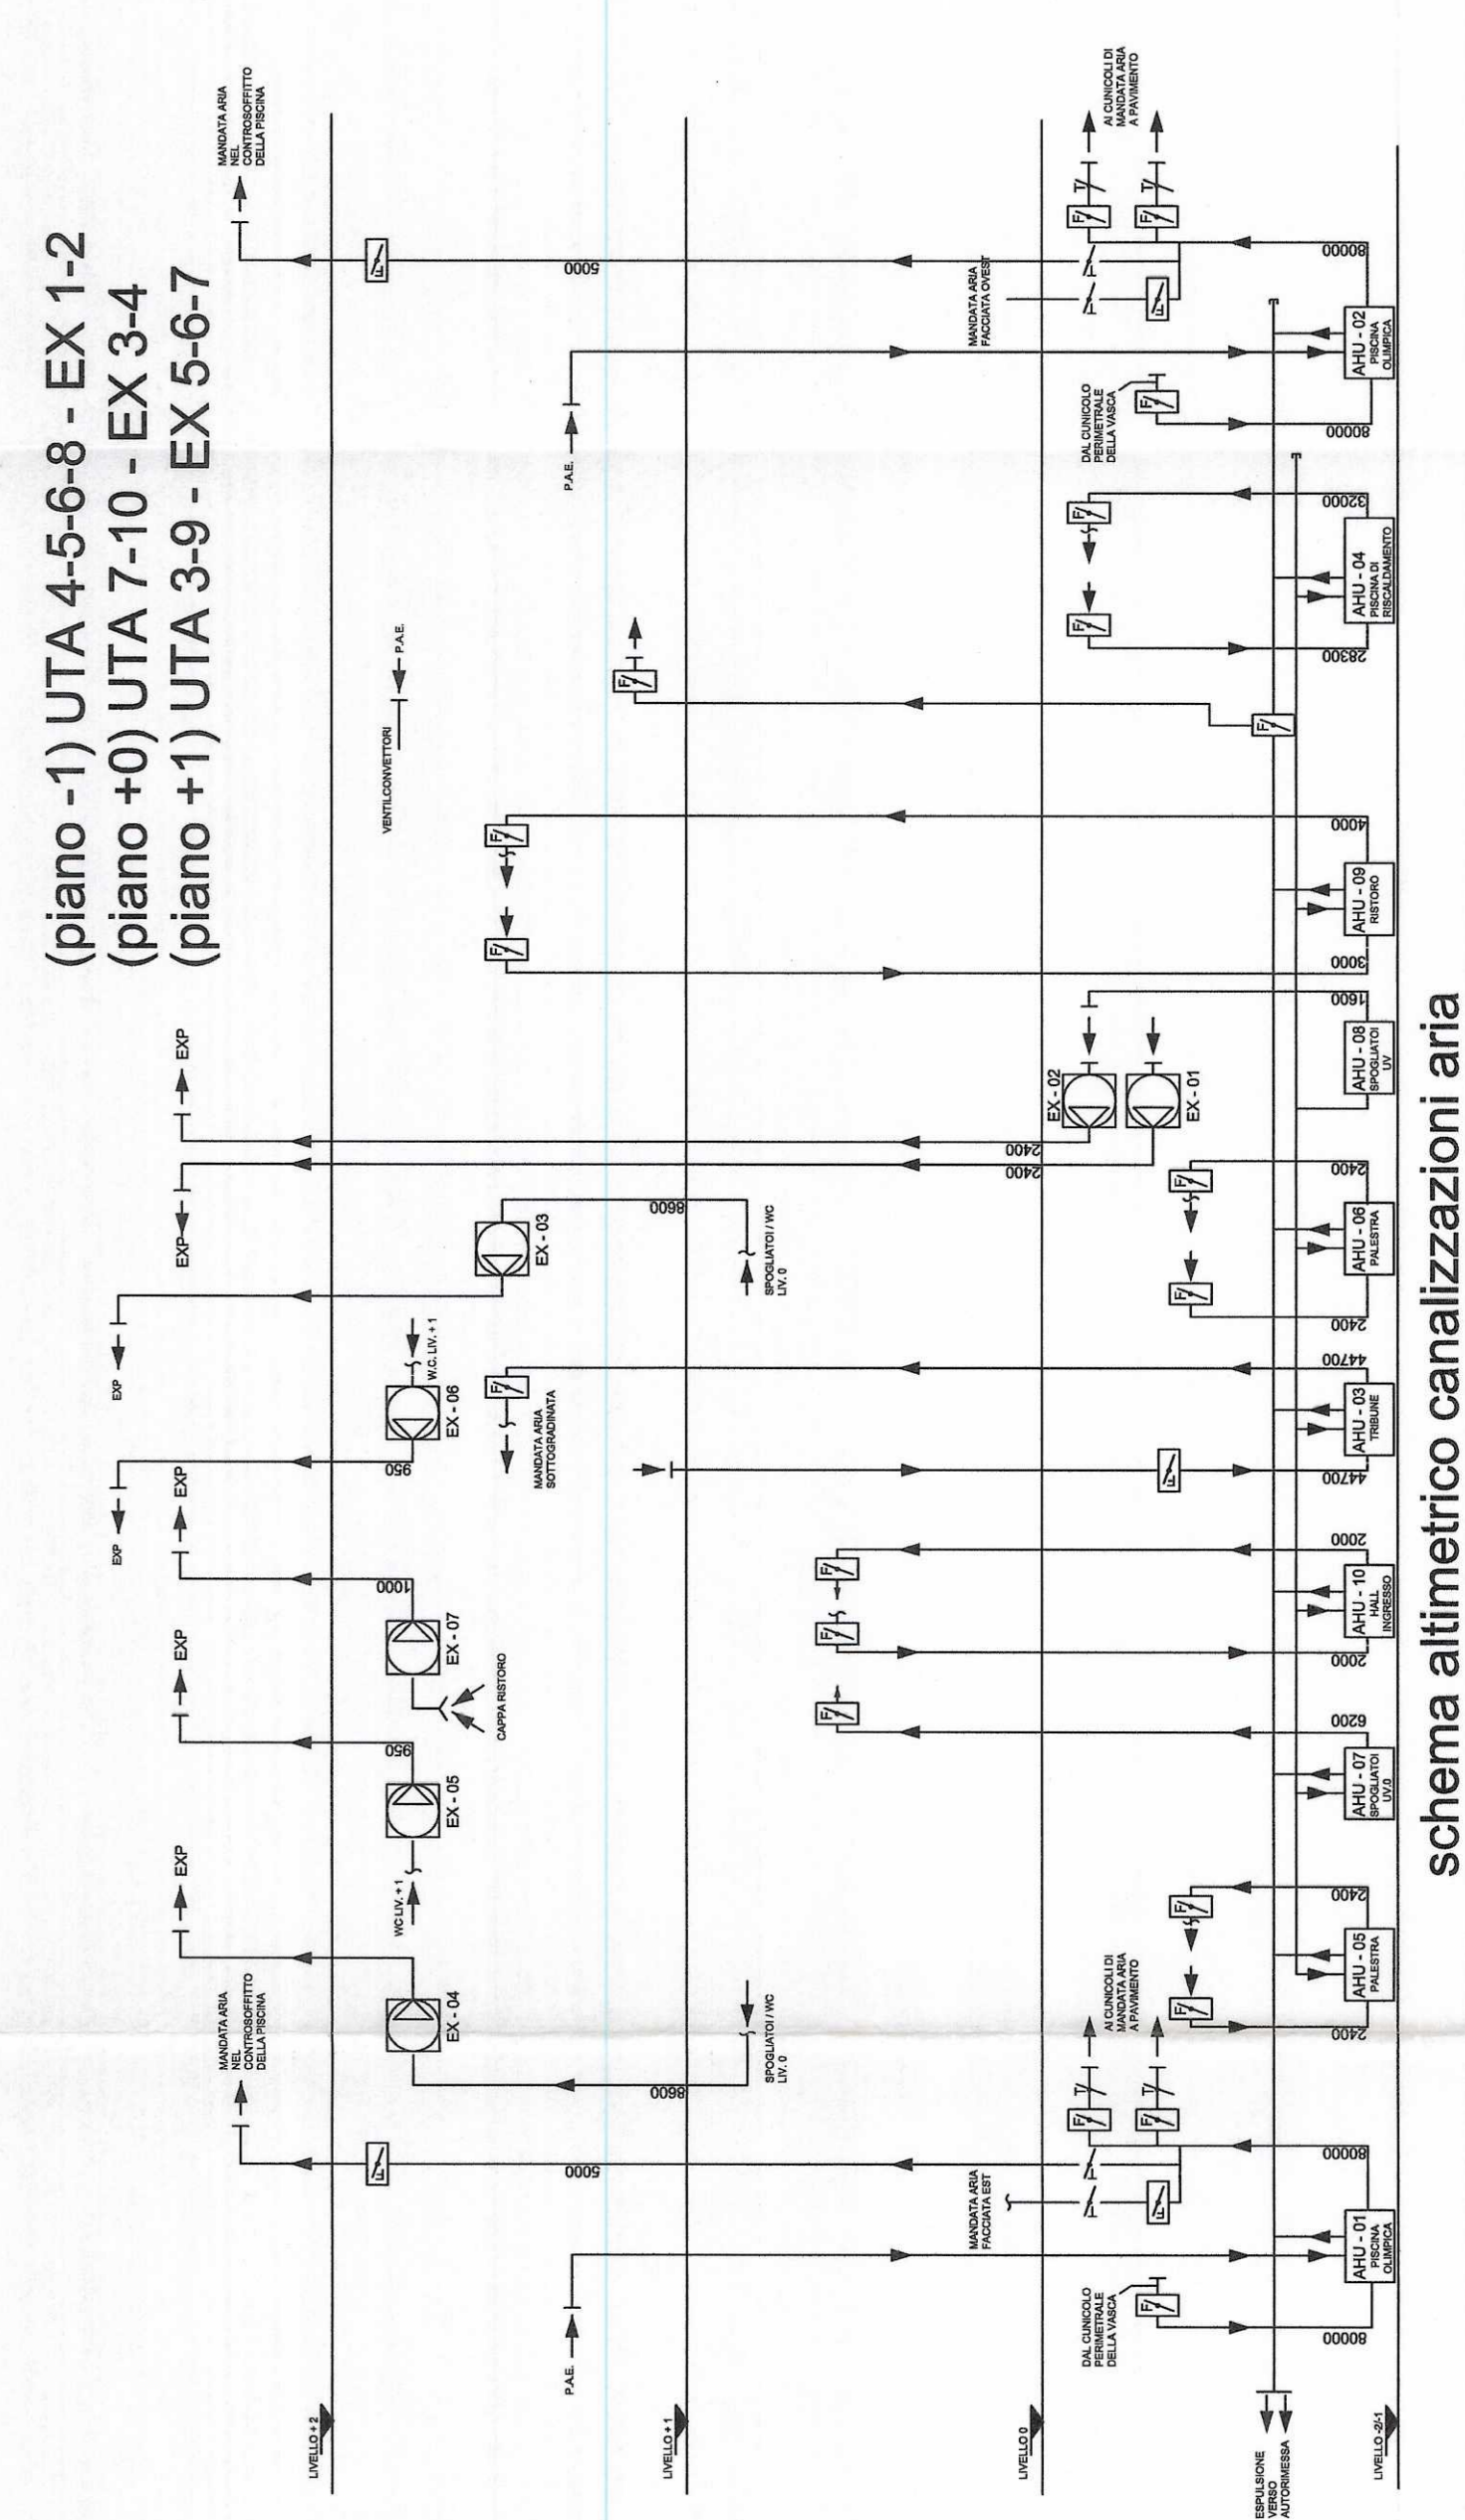

0	03/12/2010	AS BUILT	Numero	ALM	MBR	LOS
1						
2						
